


NORTH STREET

1 Basement Plan Layout

SCALE: 1/8" = 1'-0"

0 2 4 6 8 16 FEET

<p>0-10-16 A-4</p>	<p>Basement Plan Layout</p>	<p>PROPOSED FERRIN GALLERY Whaling Properties 437 & 439 North St. Pittsfield, Massachusetts</p>	<p>BLUPLAN DESIGN INC. 71 Federal Street Pittsfield, Massachusetts</p>
------------------------	-----------------------------	--	--

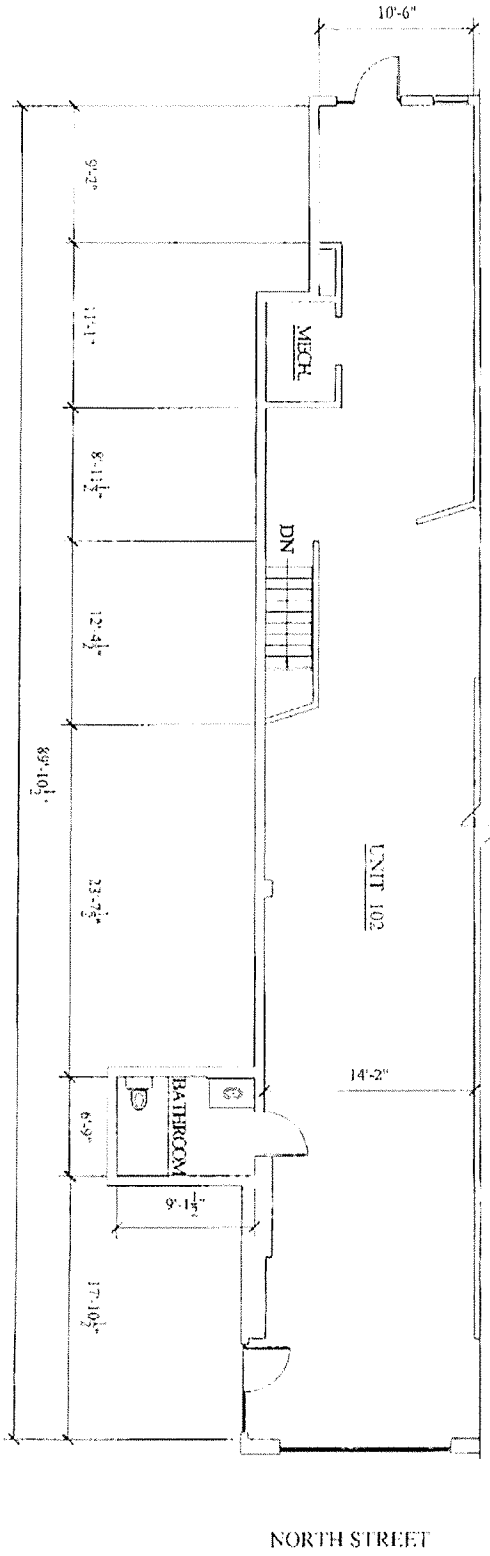

First Floor Plan Layout


0 2 4 6 8 16
FEET

Ferrin Gallery

Units 102


433 North Street, Pittsfield MA

DATE: 05.23.07

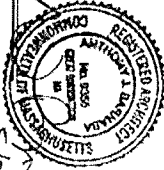


I, ANTHONY J. BARNABA, REGISTERED ARCHITECT, HEREBY CERTIFY, TO THE BEST OF MY KNOWLEDGE, INFORMATION AND BELIEF, THAT THE ATTACHED PLANS SHOW THE DIMENSIONS OF UNIT 102, AND OF THE IMMEDIATELY JOINING AREAS, AND THEY FULLY AND ACCURATELY DEPICT THE LAYOUT OF UNIT 102, ITS LOCATION, DIMENSION, ENTRANCE AND IMMEDIATE COMMON AREAS TO WHICH IT HAS ACCESS, AS BUILT.

REGISTRY USE ONLY

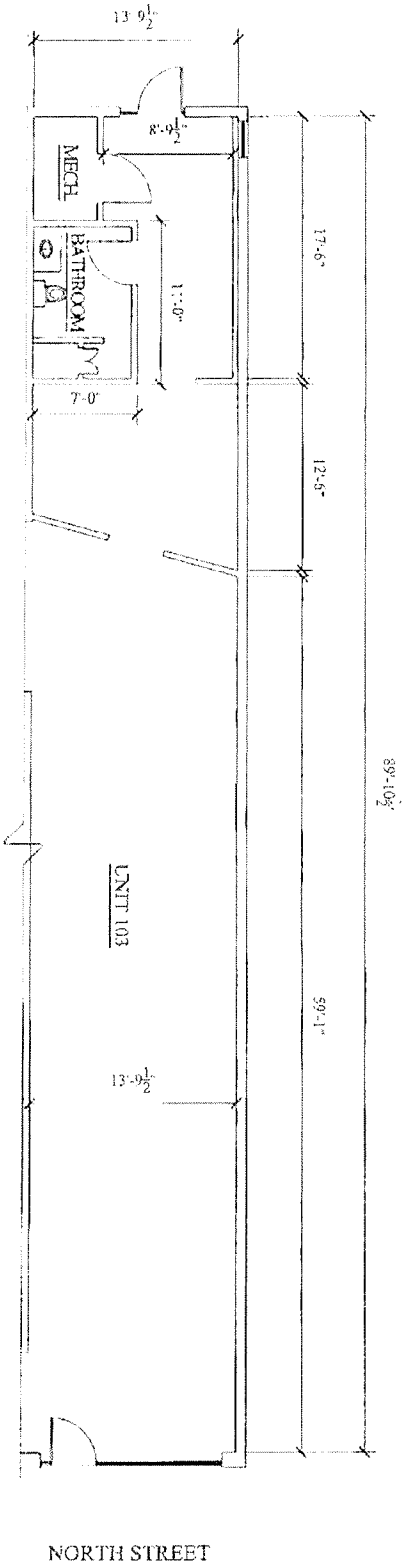

Ferrin Gallery
Unit 103
433 North Street, Pittsfield MA
 DATE: 05 23/07

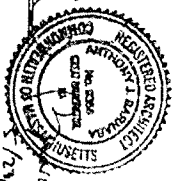

I, ANTHONY J. BARNABA, REGISTERED ARCHITECT, HEREBY CERTIFY, TO THE BEST OF MY KNOWLEDGE, INFORMATION AND BELIEF, THAT THE ATTACHED PLANS SHOW THE DIMENSIONS OF UNIT 103 AND OF THE IMMEDIATELY JOINING AREAS, AND THEY FULLY AND ACCURATELY DEPICT THE LAYOUT OF UNIT 103, ITS LOCATION, DIMENSION, ENTRANCE AND IMMEDIATE COMMON AREAS TO WHICH IT HAS ACCESS, AS BUILT.

REGISTRY USE ONLY

PLOT PLAN

